
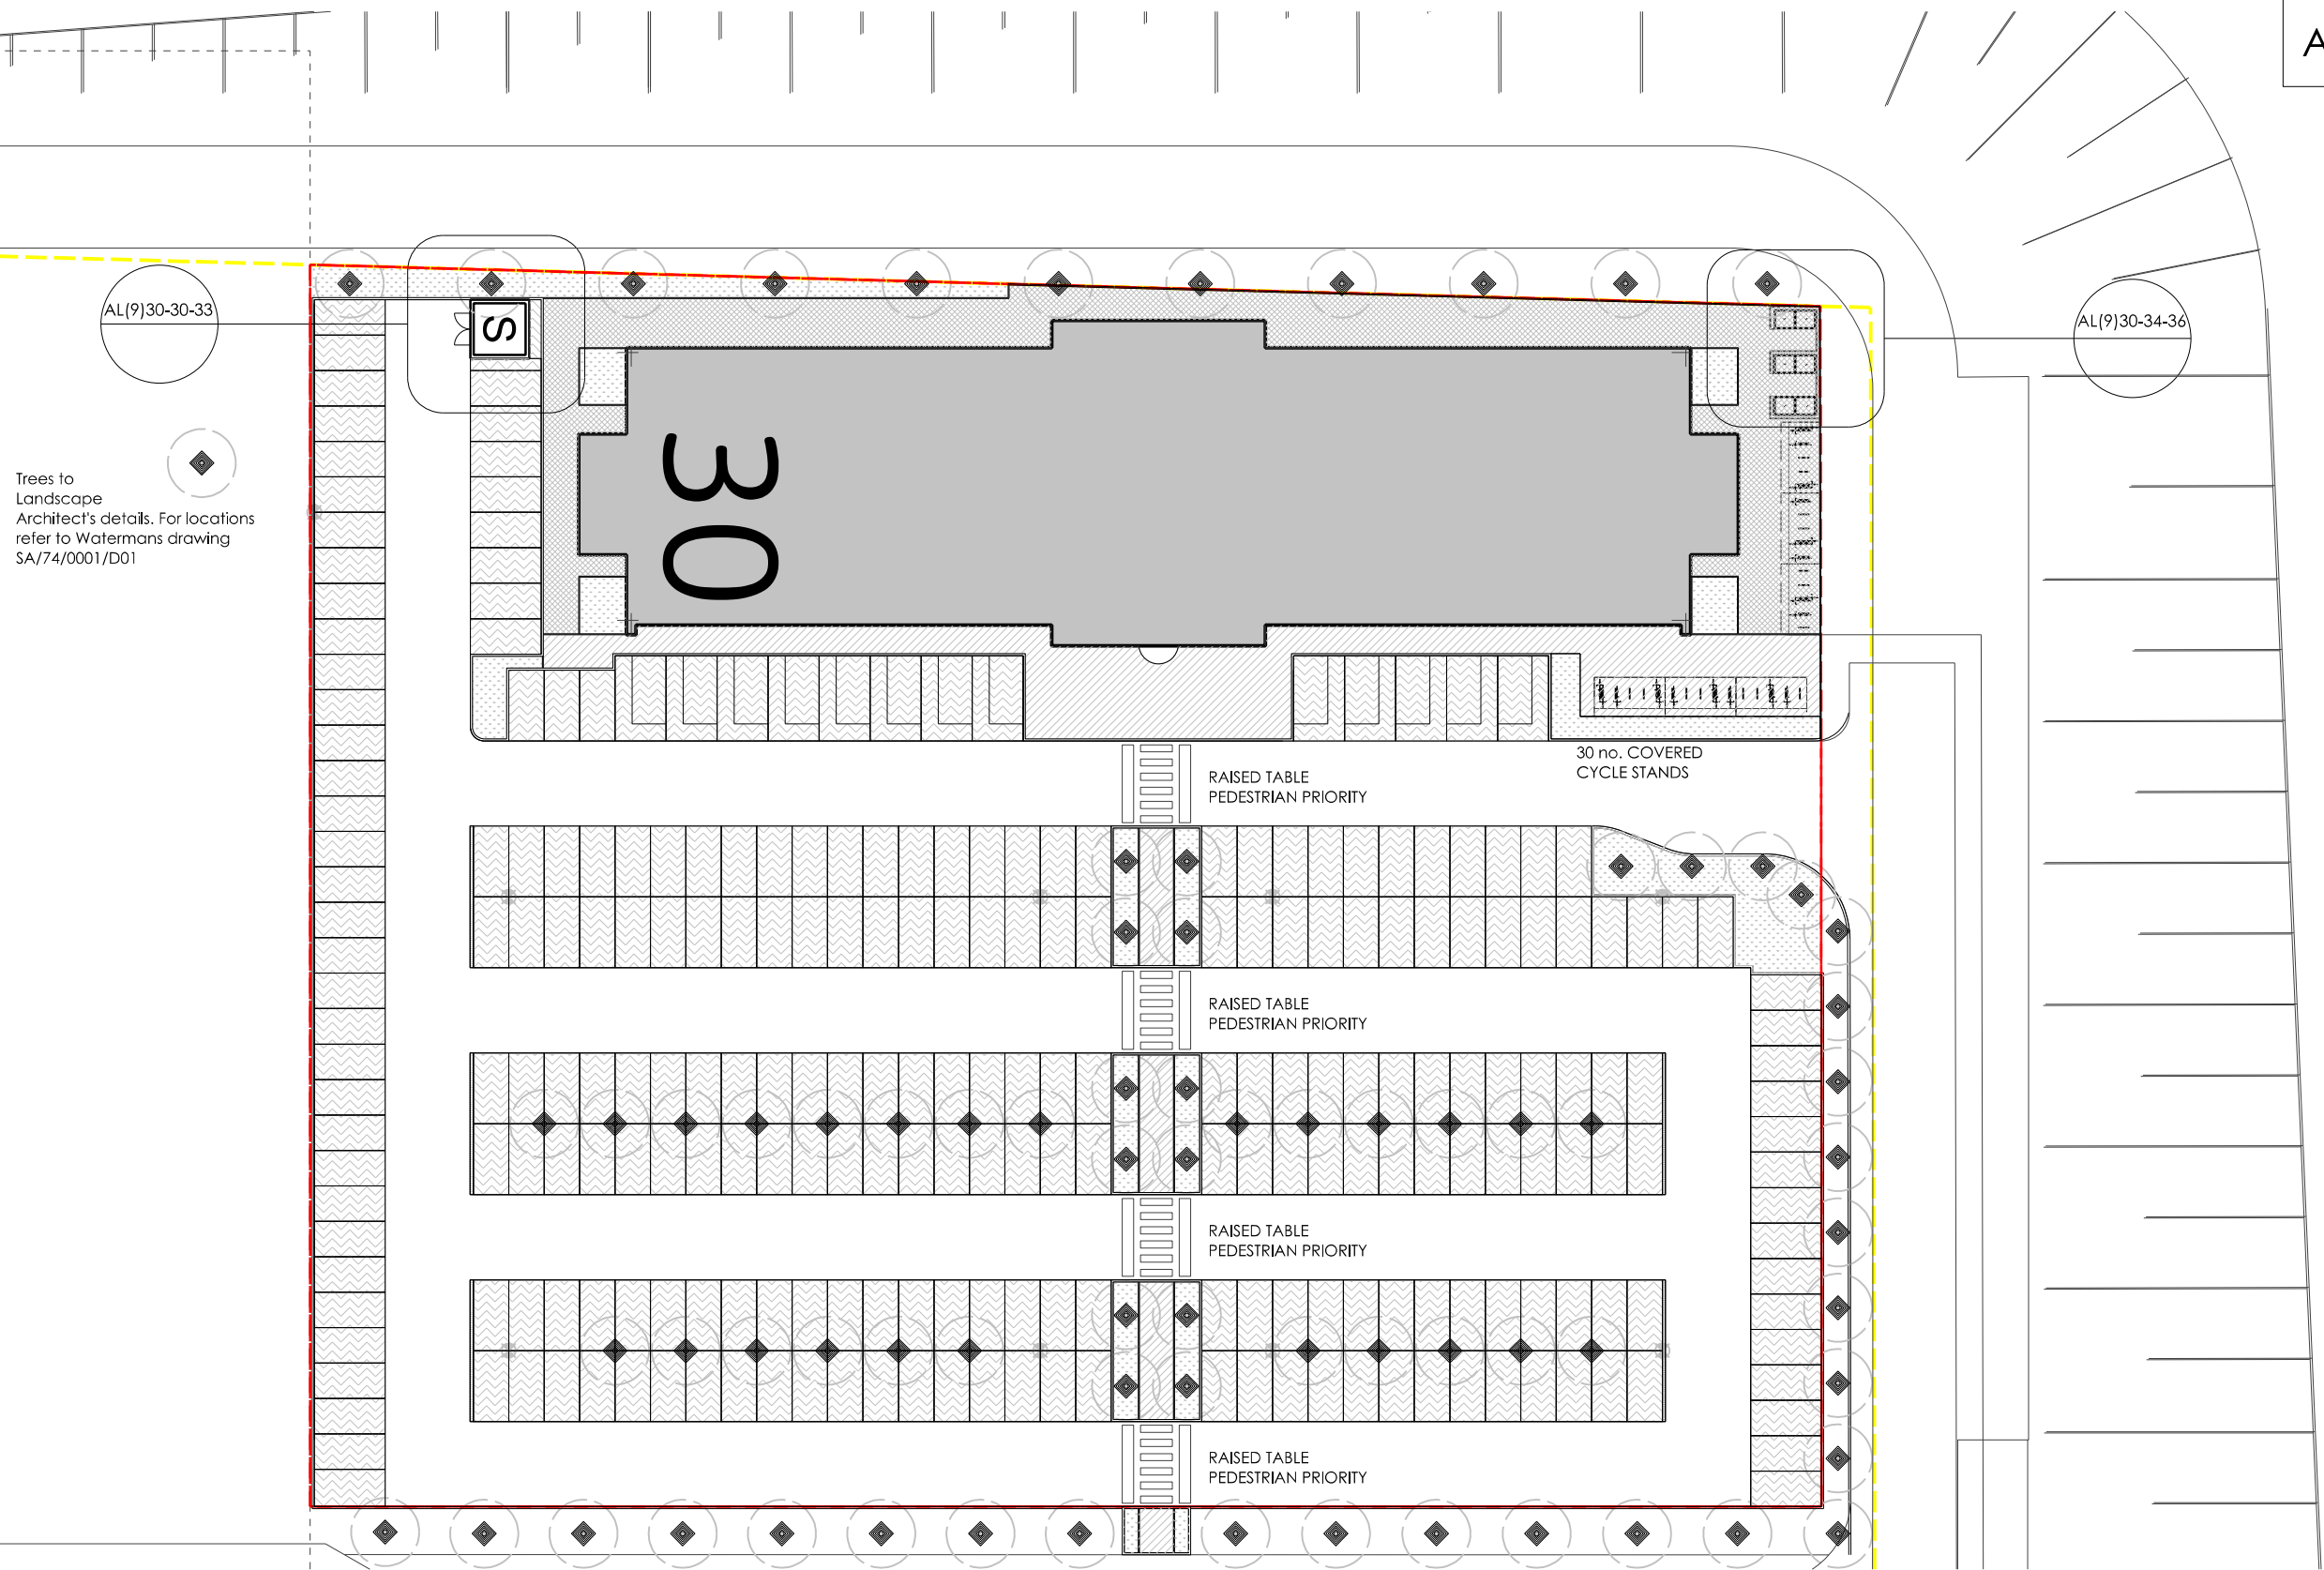



PLOT 30  
GIA: 7,253 m²  
78,068 ft²  
NIA: 5,900 m²  
63,507 ft²  
  
LAND PARCEL: 2.26 ACRES  
CAR PARKING: 259 SPACES @ 1:28

- KEY
- Marshall's Keylock Concrete block pavements (200x100xTBC) Colour: TBC
  - Soft Landscaping
  - Charcon Appalachian Concrete Flags(400x400mm) Colour: TBC
  - Marshall's Tegula Blocks (160x240x80mm, 160x160x80mm, 160x120x80mm) laid as 'Random Stretcher' Colour: TBC
  - Concrete kerb
  - Tarmac road surfacing
  - Plot Boundary
  - Enterprise Zone Boundary
  - LIGHTING COLUMN (INDICATIVE LOCATION - REFER TO ENGINEERS DRAWINGS)
  - Raised Block kerb to parking bay ends

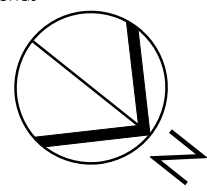

Do not scale this drawing  
Do not derive dimensions from digital media

Rev				Date				Revision Notes				Drawn by				Checked				Drawing status:				Job No:		Drawing No:				Rev:					
				06.05.11				ISSUED 'AS BUILT'												AS BUILT				2738		AL(9)30-10				M					
—				—								—				—				Job Title:				© Drawing & Design Copyright of:  FAULKNERBROWNS ARCHITECTS   Dobson House Northumbrian Way Killingworth Newcastle upon Tyne NE12 6QW  T +44(0)191 2683007 F +44(0)191 2478132											
—				—								—				—				Drawing Title:															
—				—								—				—				PLOT 30 SITE PLAN															
—				—								—				—				Date:												Scale:		Drawn By:	
—				—								—				—				01.04.10		1:500		LJC		SMCI									